


GRADING PLAN


LOT _____ X
 BLOCK _____ X
 PLAN _____ X

CLIENT NAME X Homes
 SITE ADDRESS X Way N.W.
Calgary, Alberta

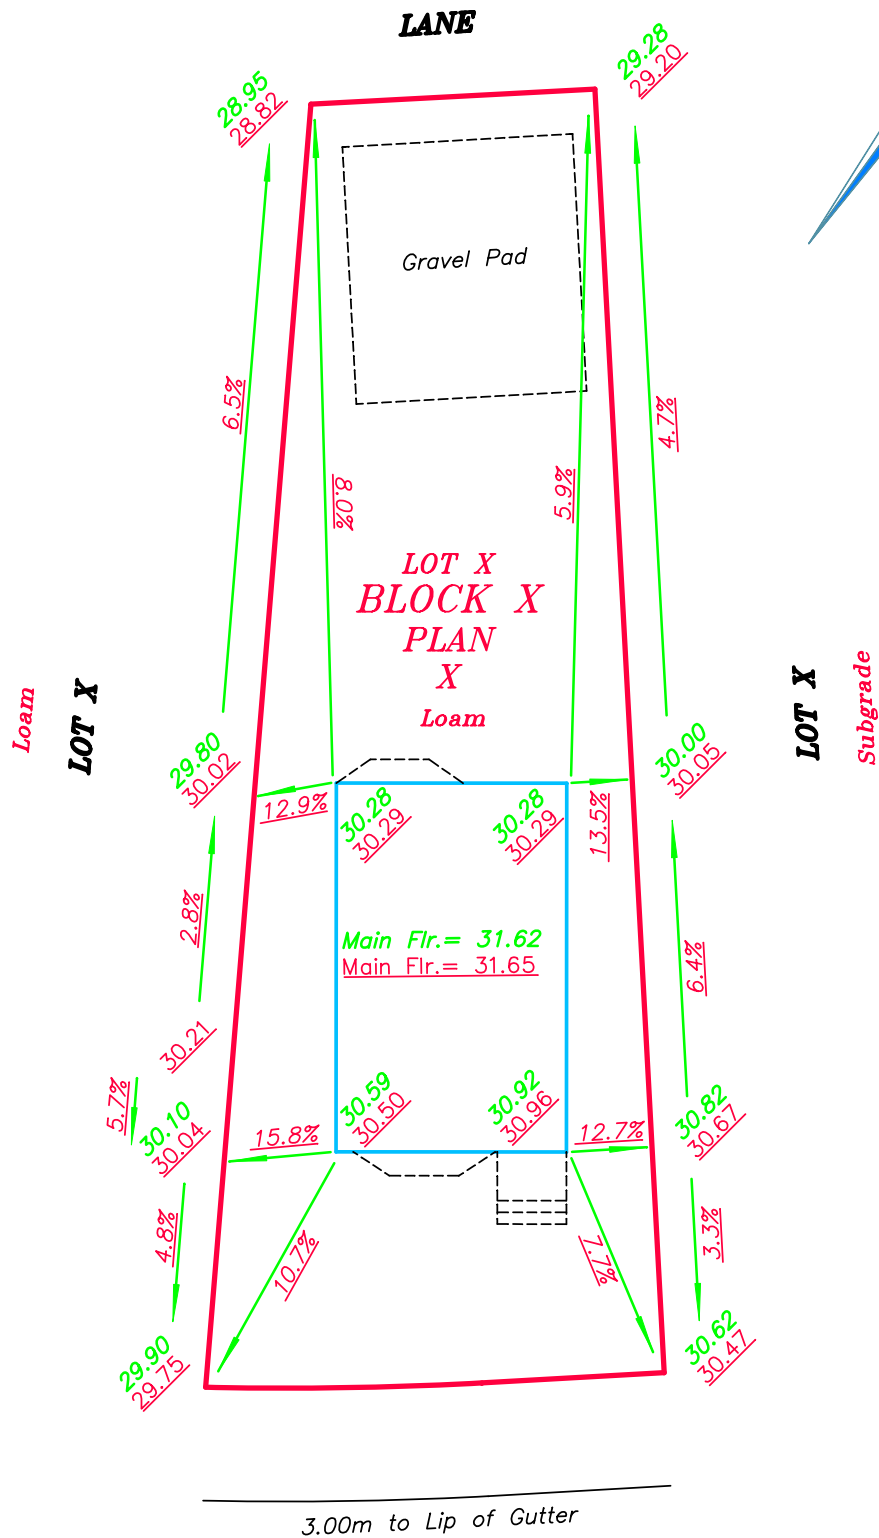

Dennis G. Clayton, A.L.S.

X WAY N.W.

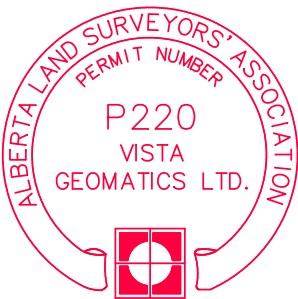

Scale = 1 : 200

PREPARED BY: **VISTA GEOMATICS LTD.**

NOTES

Grades are metric.
 Design grades are shown thus ... 100.00
 As built grades are shown thus ... 100.00
 Drawn by: X

DATE: November X, 2009
 Bay 1, 2135 - 32nd Ave. N.E.
 Calgary, Alberta T2E 6Z3
 Phone (403) 270-4048
 E-mail: admin@vistageomatics.com
 VISTA FILE NO. 09L1X